THIS DRAWING IS UNPUBLISHED. RELEASED FOR PUBLICATION ,1995 .
© COPYRIGHT 1995 ALL RIGHTS RESERVED.

LOC	DIST
J	

REVISIONS 変更

P	LTR	DESCRIPTION	DATE	DWN	APVD
	C3	REVISED PER ECO-11-005030	11MAR11	RK	HMR

注 記

1. 材料 ハウジング ガラス入り熱可塑性
ポリエステル樹脂(94V-0),色 黒
2. ~~ハウジング全面にテフロン塗装のこと~~

NOTES

1. MATERIAL:HOUSING:GLASS FILED THERMO PLASTIC
,POLYESTER(94V-0),COLOR:BLACK
2. ~~TO COAT ALL SURFACE OF HOUSING WITH TEFLON~~

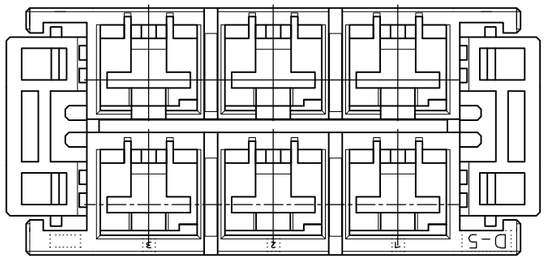

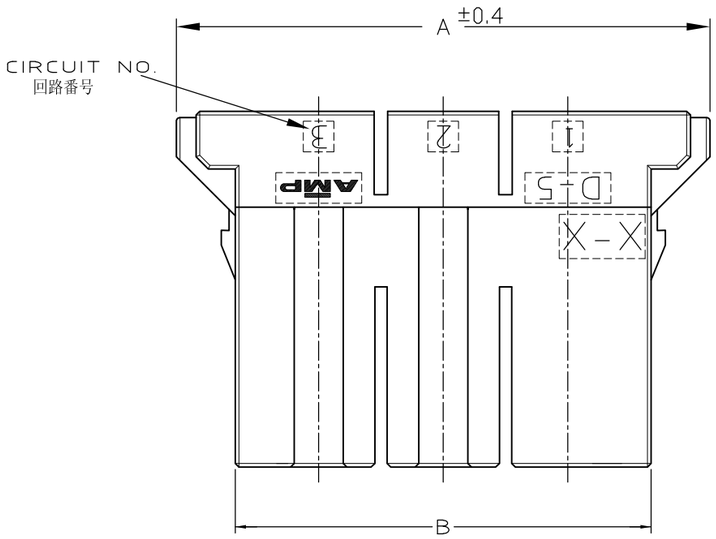

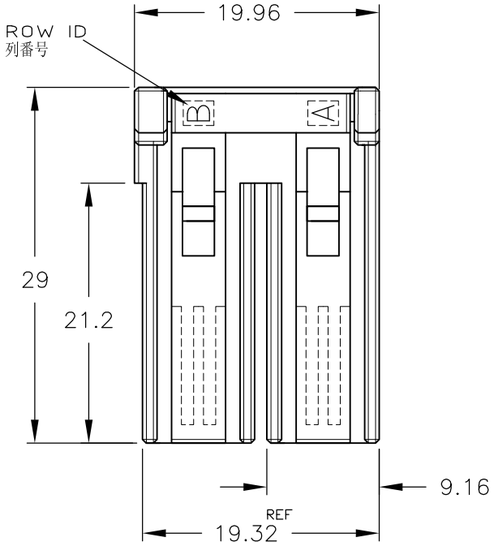

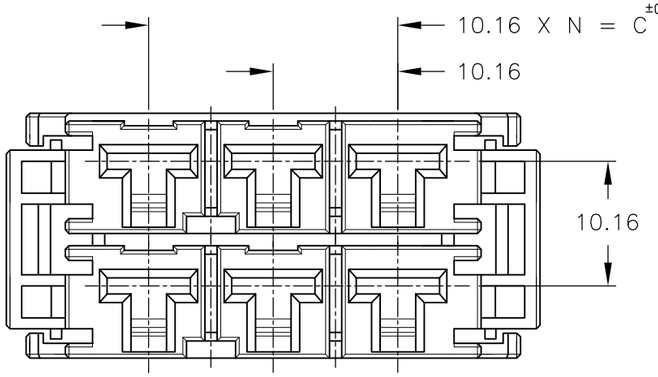

KEYING CODE:X-X
1-917807-3

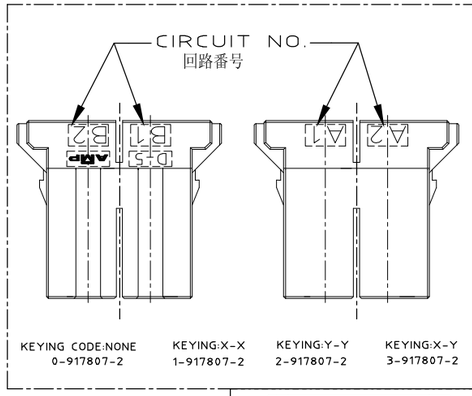

KEYING CODE:NONE 0-917807-2 | KEYING:X-X 1-917807-2 | KEYING:Y-Y 2-917807-2 | KEYING:X-Y 3-917807-2

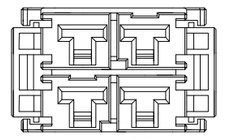

KEYING CODE:X-Y
3-917807-2

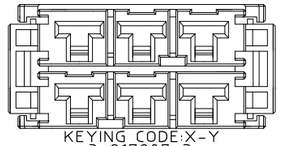

KEYING CODE:X-Y
3-917807-3

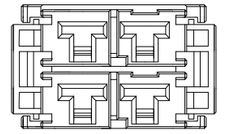

KEYING CODE:Y-Y
2-917807-2

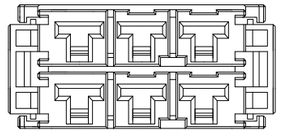

KEYING CODE:Y-Y
2-917807-3

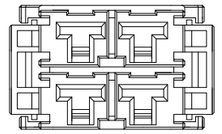

KEYING CODE:NONE
0-917807-2

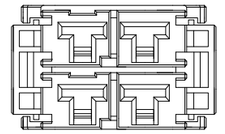

KEYING CODE:X-X
1-917807-2

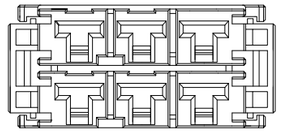

KEYING CODE:X-X
1-917807-3

OBSOLETE	~~2~~					~~5-917807-3~~
						3-917807-3
						2-917807-3
	20.32	33.92	43.52	2	6	1-917807-3
OBSOLETE	~~2~~					~~6-917807-2~~
OBSOLETE	~~2~~					~~5-917807-2~~
						3-917807-2
						2-917807-2
						1-917807-2
	10.16	23.76	33.36	1	4	0-917807-2
FINISH	C	B	A	N	POS	P/N

WIRE RANGE 抱合電線断面積 | INSULATION DIA 被覆外径

DIMENSIONS: 単位 特記 mm

TOLERANCES UNLESS OTHERWISE SPECIFIED
一般公差
10以下 : ±0.2
30以下 >10 : ±0.25
100以下 >30 : ±0.3
ANGLE : ±0.3°

MATERIAL 材料 1

FINISH 仕上

DWN K.IKEDA 31/OCT/'95
CHK Y.ISHIKAWA 31/OCT/'95
APVD S.MANABE 1/NOV/'95
PRODUCT SPEC 製品規格 108-5453
APPLICATION SPEC 取付適用規格 114-5206
WEIGHT T1

TE Connectivity

NAME 名称: 2列 リセ ハウジング
DOUBLE ROW REC HSG
<DYNAMIC D-5200 M>

SIZE	CAGE CODE	DRAWING NO 番号
A3	00779	917807

CUSTOMER DRAWING

SCALE 尺度	SHEET	REV
2-1	1 OF 1	C3

顧客用図面